



NO.	ISSUE REVISION	BY	DATE
0	Building Consent	ND	5.08.05
1	General Revisions	SL	21.11.05
3	General Revisions	CG	21-12-05
4	D12 Amended	SL	11-01-06
5	Resource Consent	SL	27-03-06

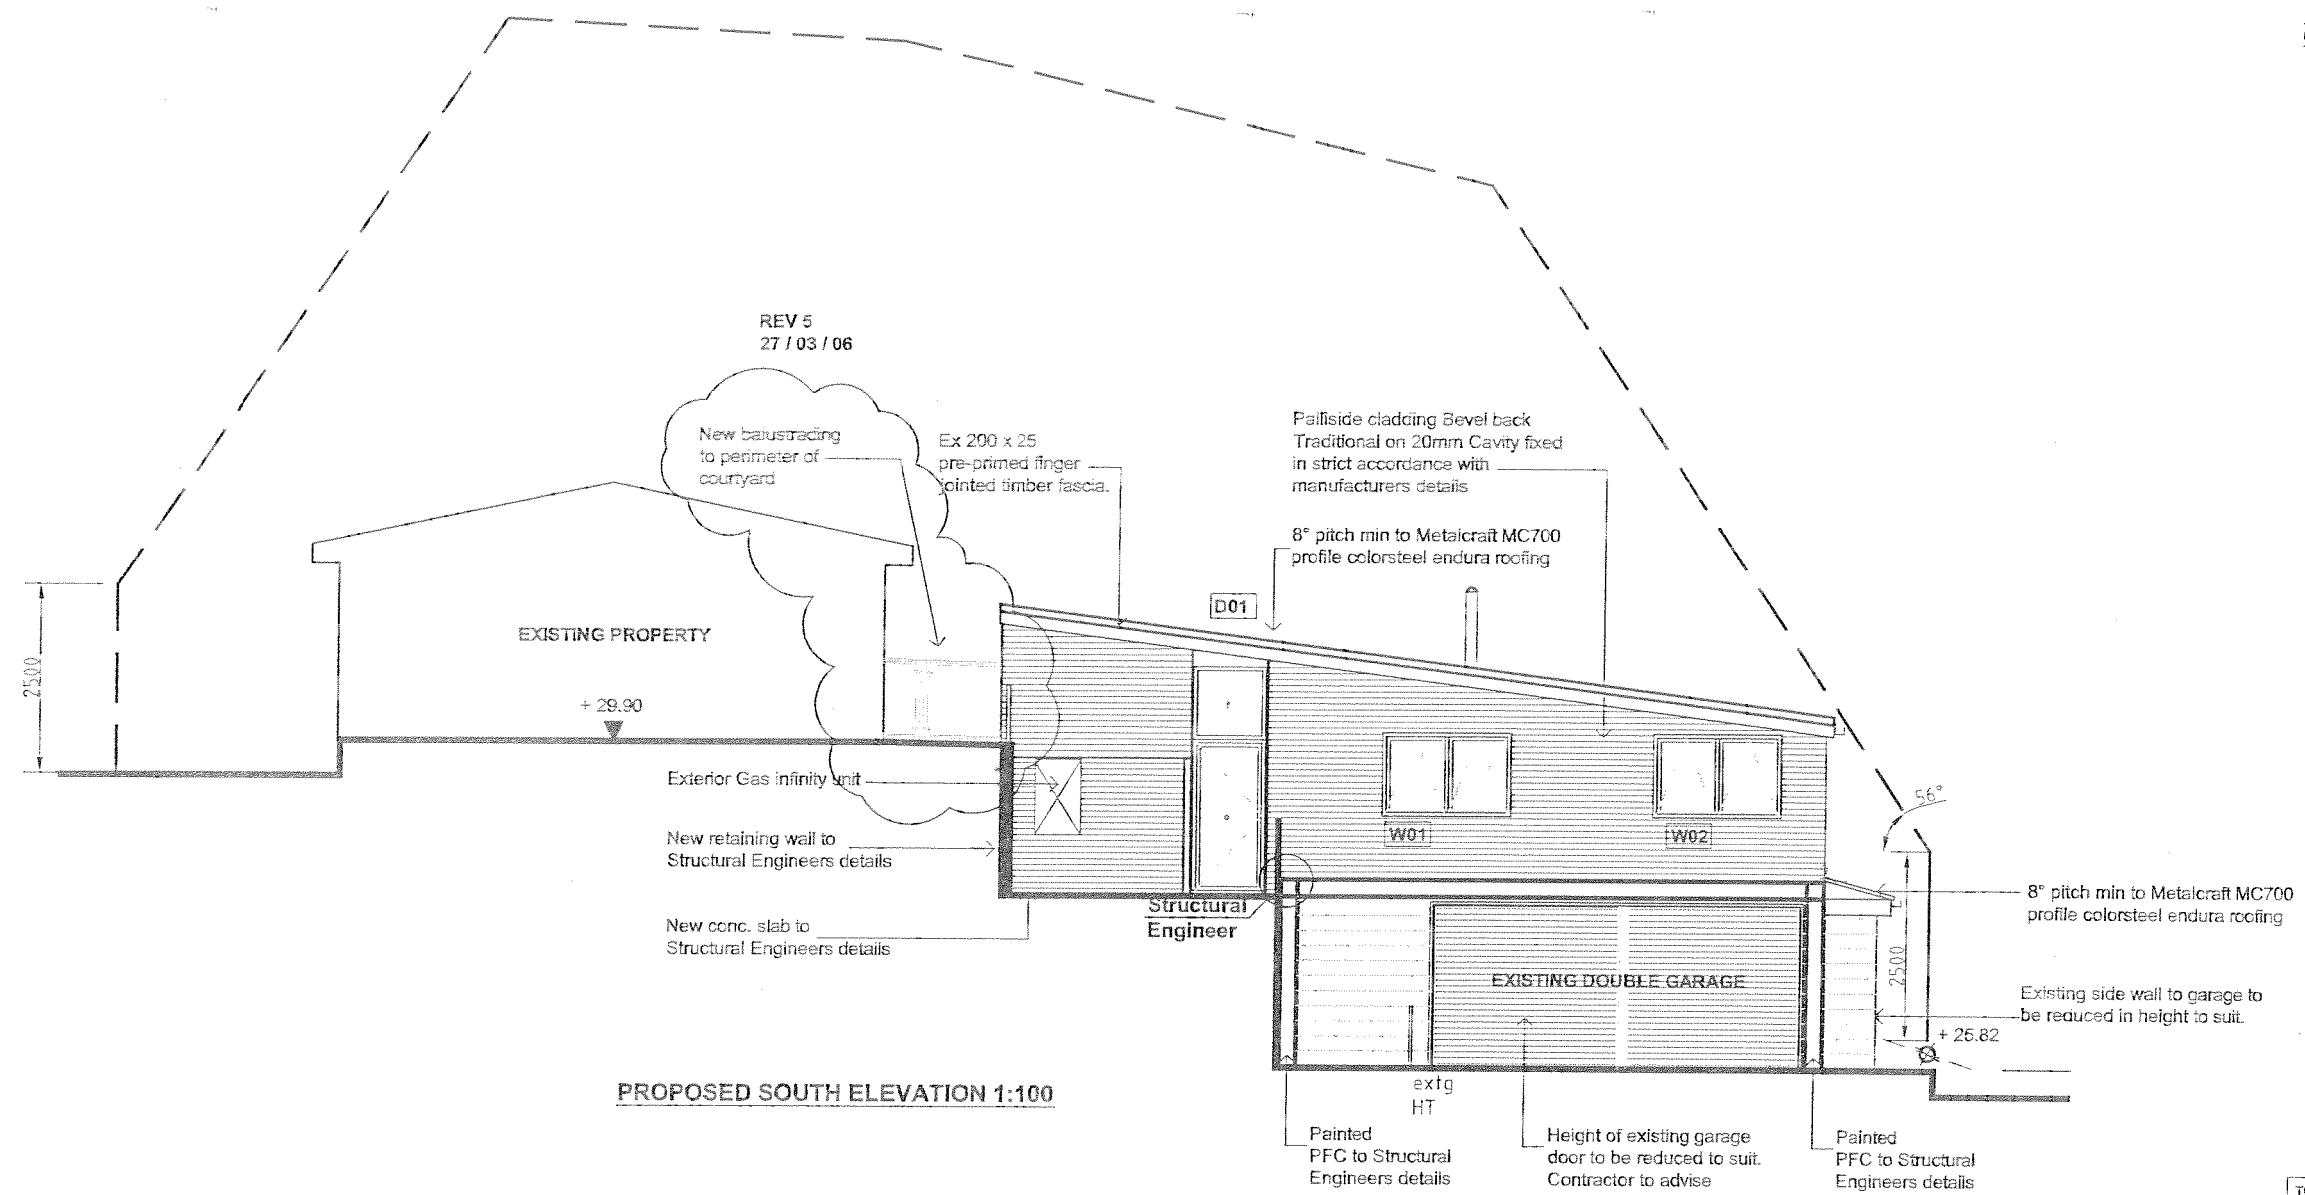

PROPOSED SOUTH ELEVATION 1:100

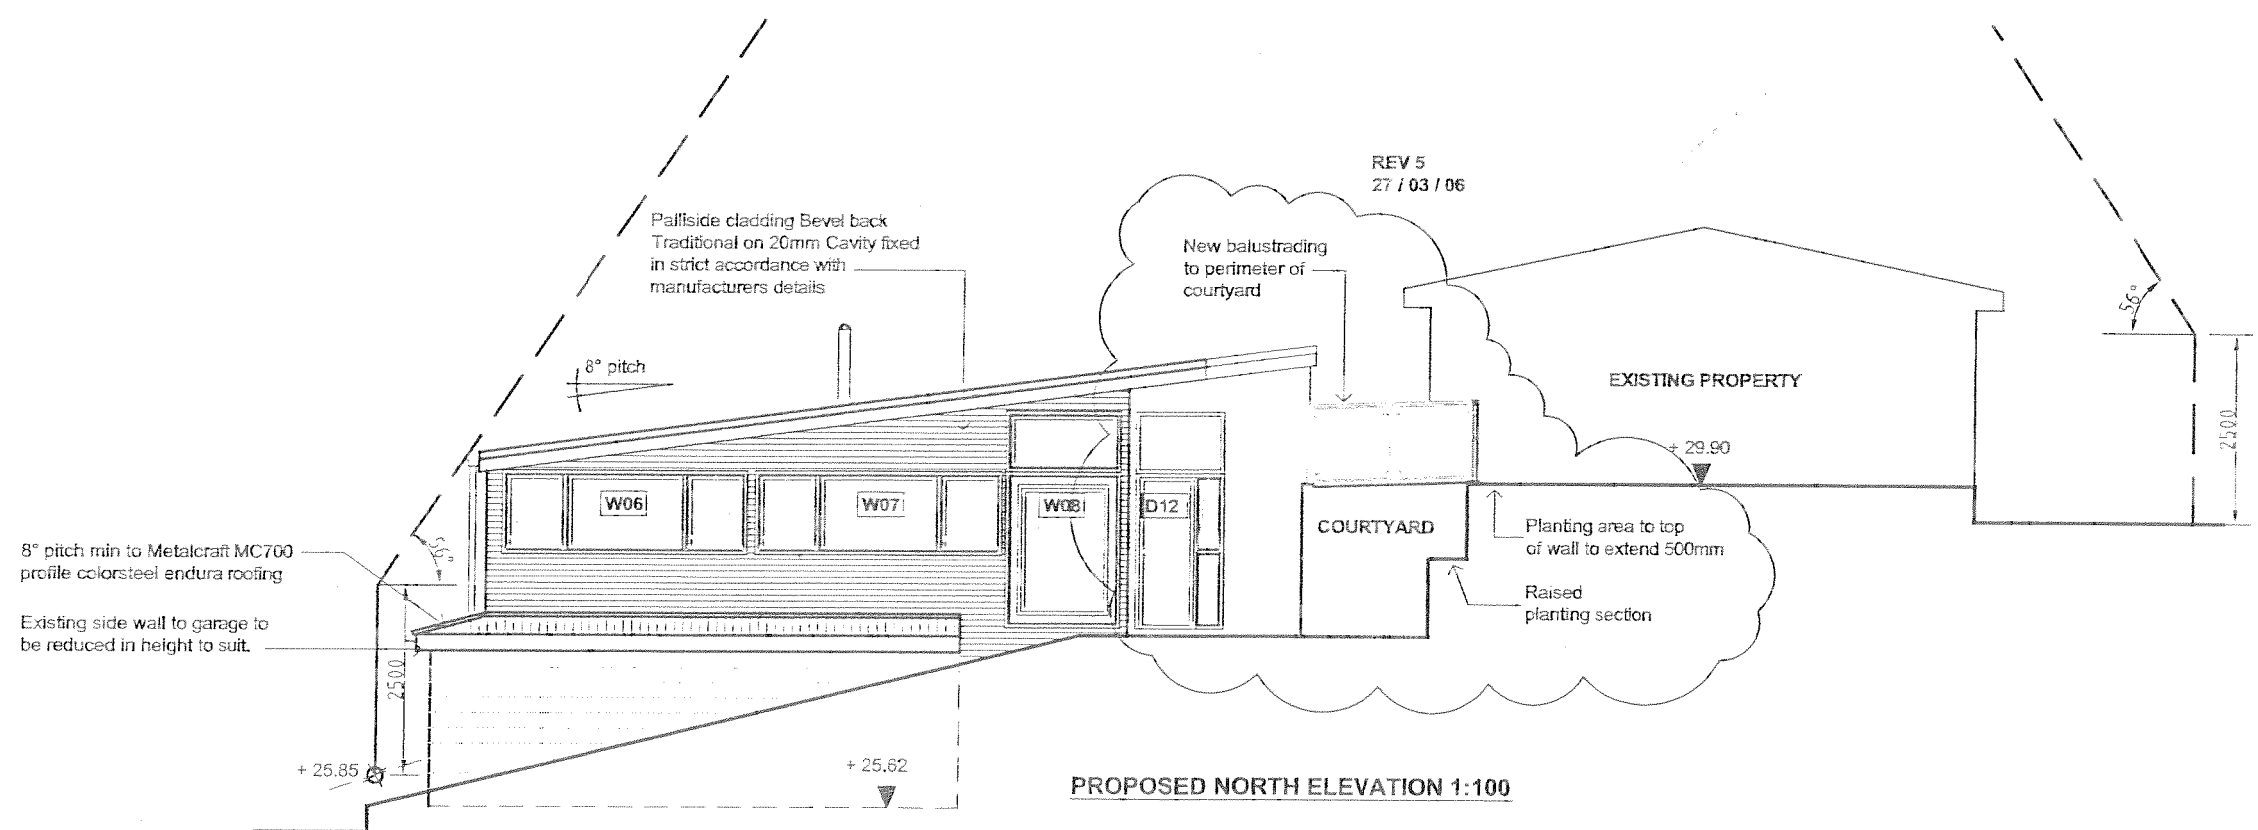

PROPOSED NORTH ELEVATION 1:100

PROPOSED NORTH + SOUTH ELEVATIONS 1:100

TO BE READ IN CONJUNCTION WITH STRUCTURAL ENGINEERS DETAILS
 ALL DIMENSIONS TO BE CHECKED ON SITE PRIOR TO CONSTRUCTION
 ALL WORKS TO COMPLY WITH NZS 3604 AND ALL SECTIONS OF THE NEW ZEALAND BUILDING CODE

designgroup
stapleton architects
www.designgroup.co.nz • info@designgroup.co.nz
P.O. Box 11-142 Lower Hutt, New Zealand
Tel: 04 569-7900 Fax: 04 569-1118

DRAWING NAME
Proposed Elevations


Scale: A3 1:100

DRAWING STATUS	ISSUE DATE
for information	
for approval	
for consent	
for tender	5 Aug 2005
for contract	
as built	

JOB NO.	DESIGNED	DRAWN	CHECKED	DATE	SHEET NO.	IN SET OF	REV.
2423	DSA	SL	ND	21-12-05	A300	5	

Contractors must verify all dimensions on the job before commencing work. Copyright of this drawing is vested in Designgroup Stapleton Architects.

NO.	ISSUE REVISION	BY	DATE
0	Building Consent	ND	5-08-05
1	General Revisions	SL	21-11-05
3	General Revisions	CG	21-12-05
5	Resource Consent	SL	27-03-06

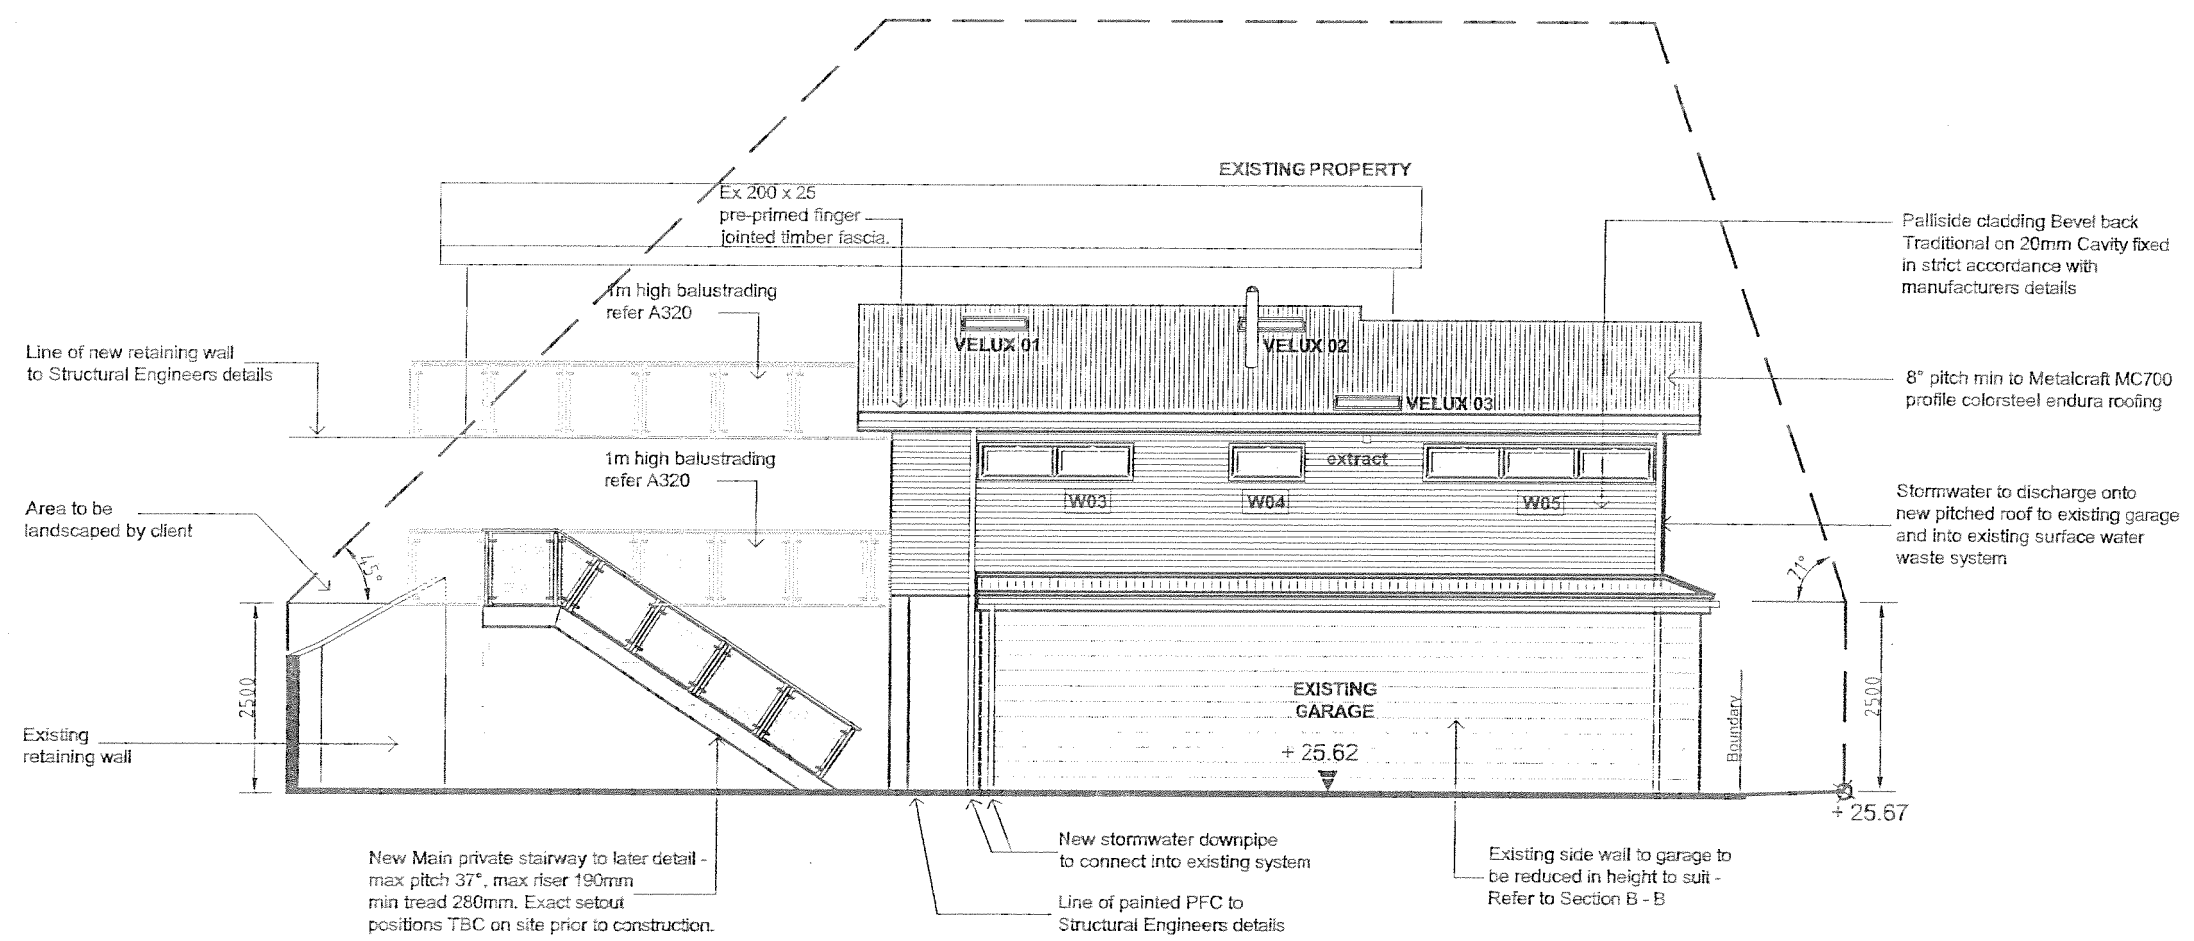


PROPOSED EAST ELEVATION 1:100

TO BE READ IN CONJUNCTION WITH
STRUCTURAL ENGINEERS DETAILS

ALL DIMENSIONS TO BE CHECKED
ON SITE PRIOR TO CONSTRUCTION

ALL WORKS TO COMPLY WITH NZS
3604 AND ALL SECTIONS OF THE
NEW ZEALAND BUILDING CODE

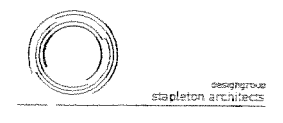

www.designgroup.co.nz • stapleton@designgroup.co.nz
P.O. Box 31-142 Lower Hut New Zealand
Tel: 04 568-7990 Fax: 04 560-7118

PROJECT TITLE

DRAWING NAME
Proposed Elevations

Scale	1:100
DRAWING STATUS	ISSUE DATE
for information	o
for approval	o
for contract	o
for tender	o
for contract	o
as built	o

5 Aug 2005

JOB NO.	2423	SHEET NO.
DESIGNED	DSA	A310
DRAWN	SL	IN SET OF
CHECKED	ND	REV.
DATE	21-12-05	5

Contractors must verify all dimensions on the job before commencing work.
Copyright of this drawing is vested in Designgroup Stapleton Architects

PROPOSED EAST ELEVATION 1:100

